
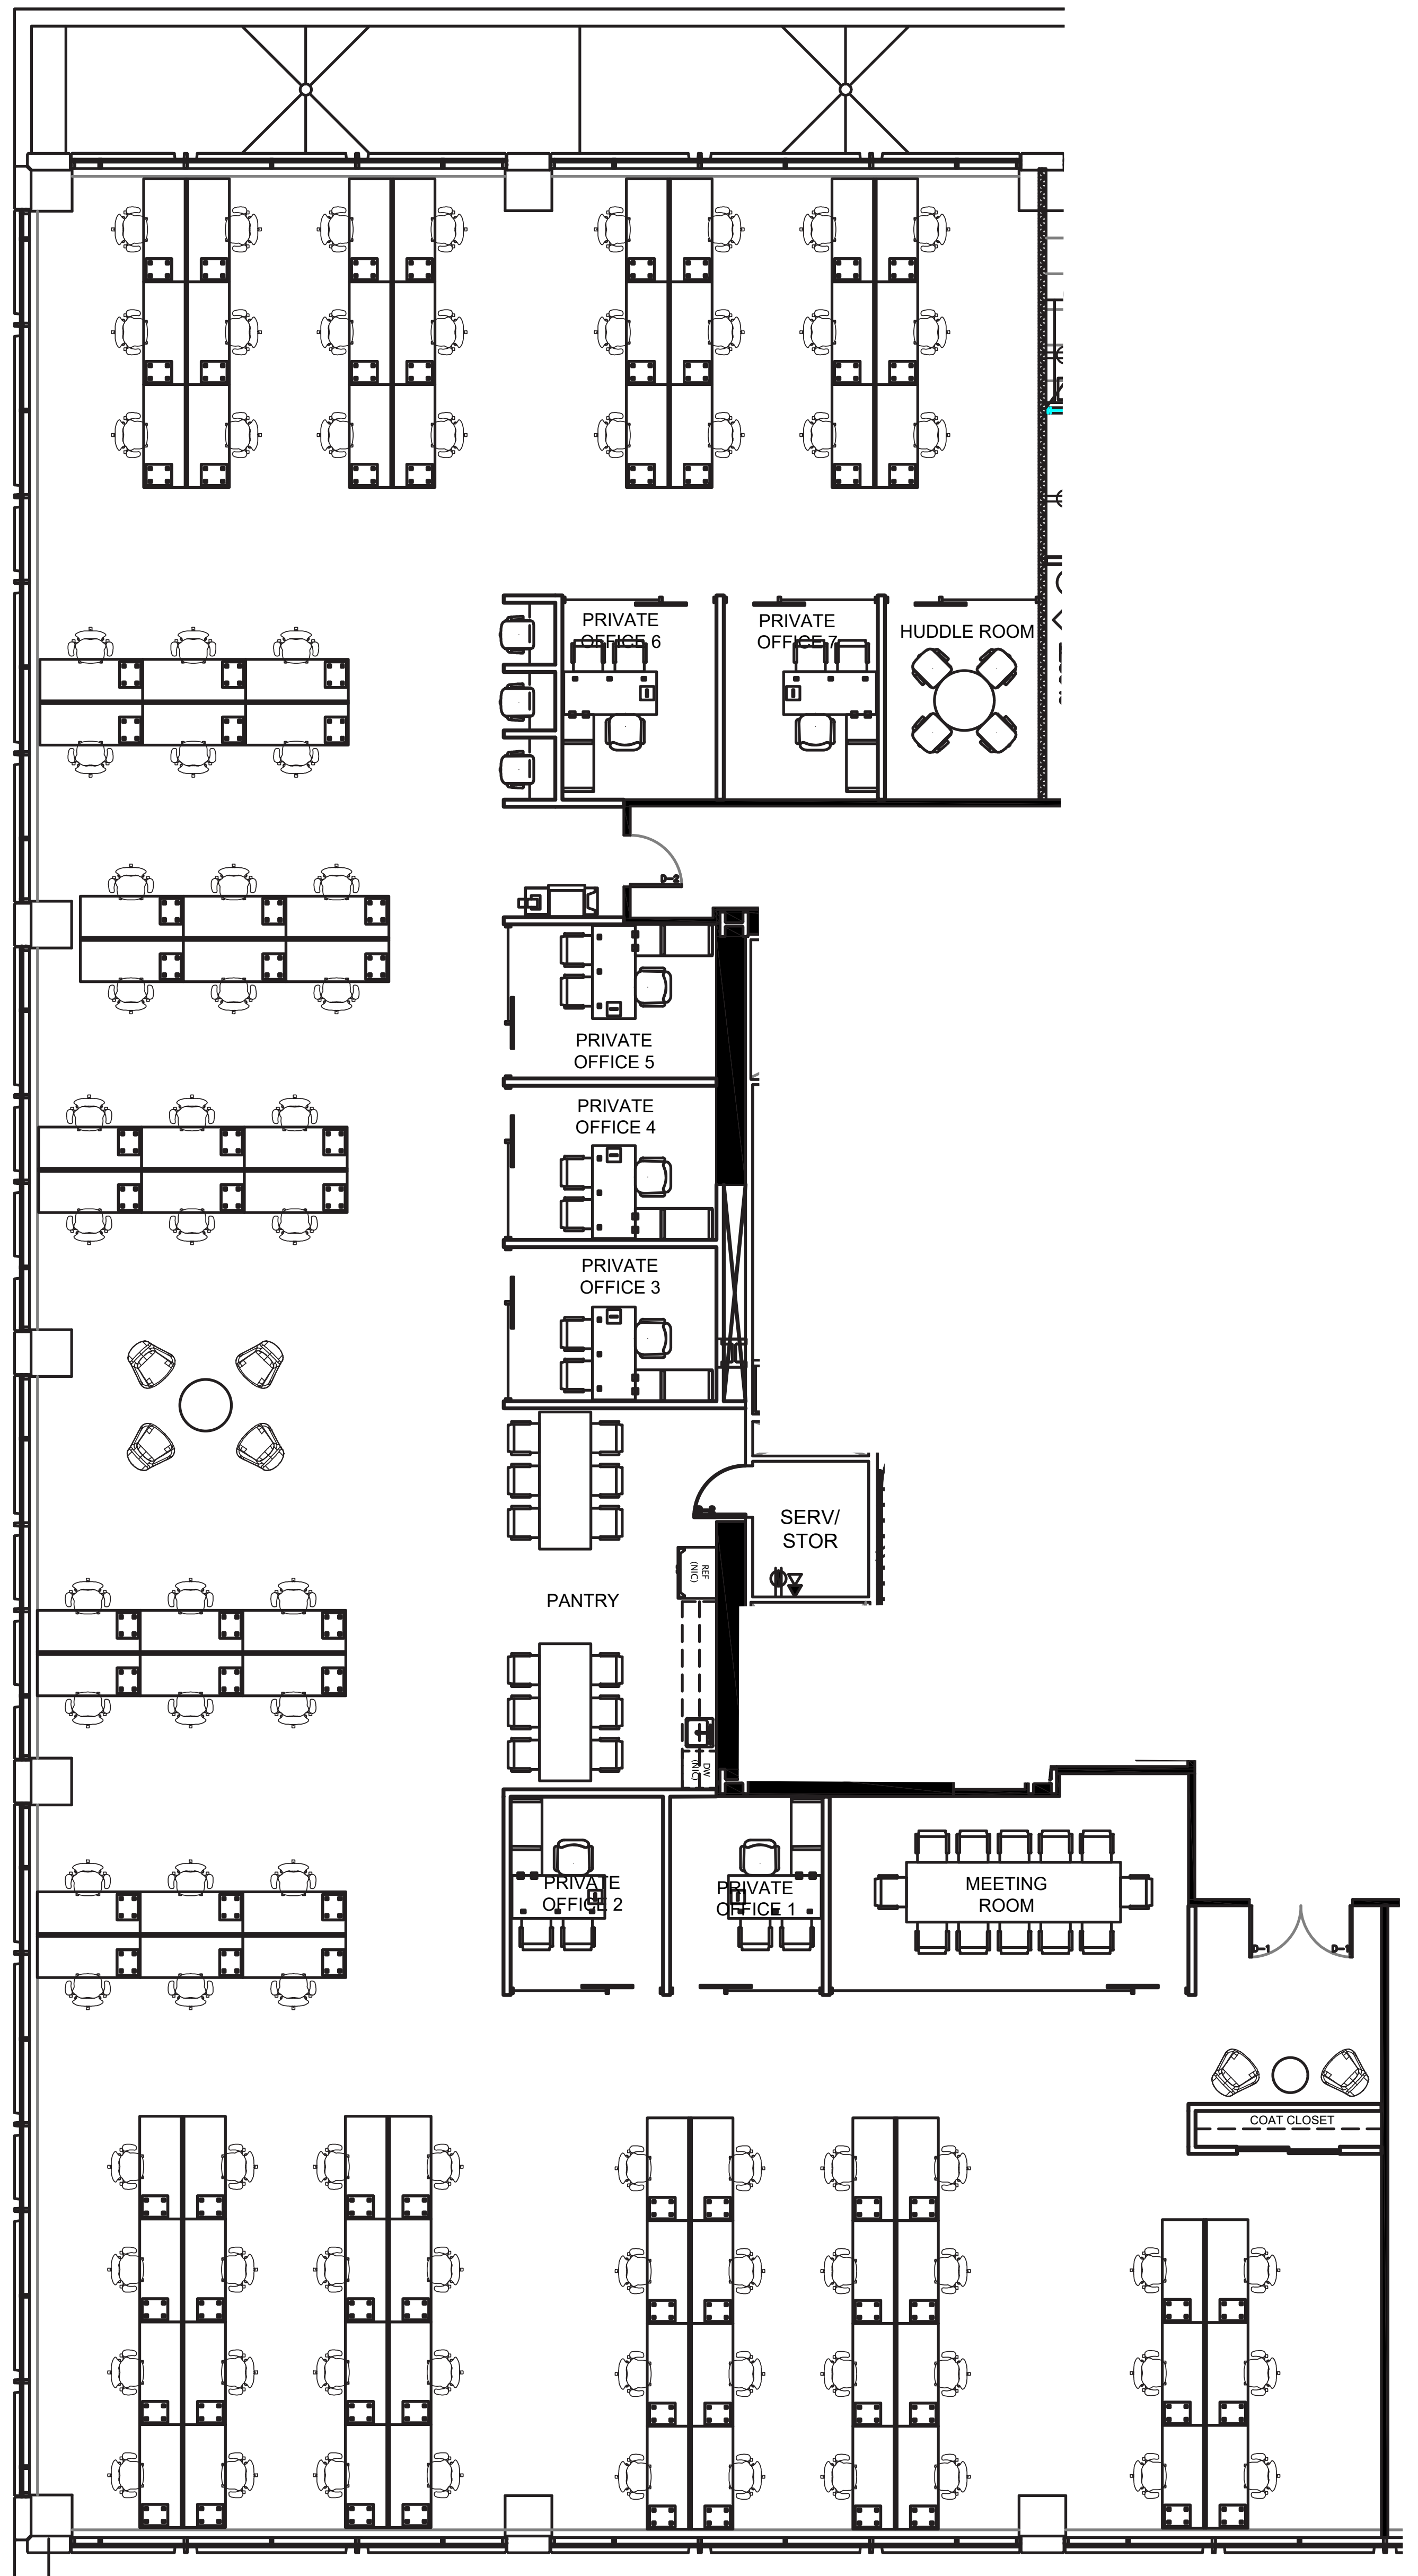


AS-BUILT CONFIGURATION

OFFICES.....	7
RECEPTION.....	1
CONFERENCE ROOMS.....	2
KITCHEN.....	1
OPEN WORK AREA.....	92

*Not to scale, furniture and appliances not included*

KEY PLAN

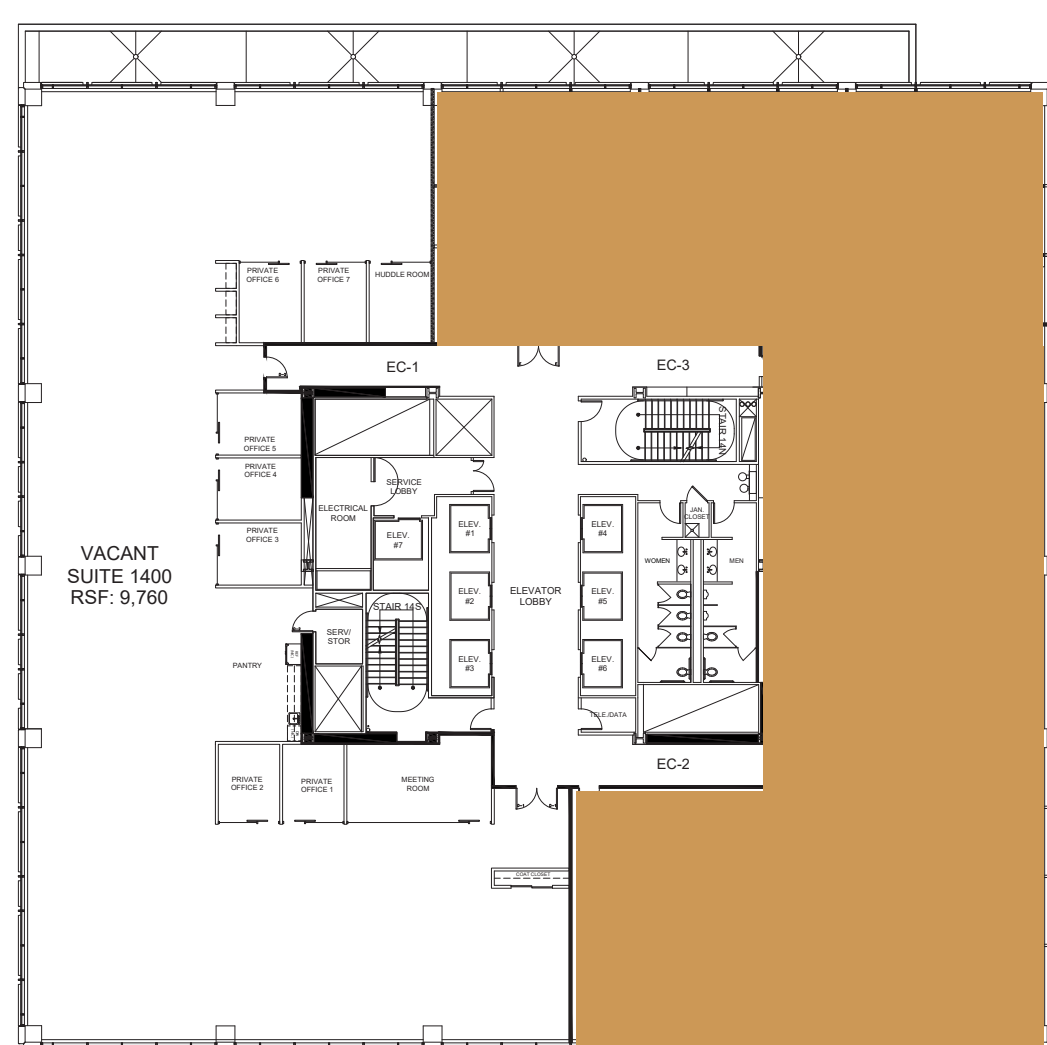

For leasing information please contact:  
 Mark J. Gunderson  
 312.819.1236  
 mark.gunderson@cushwake.com

Ben Cleveland  
 312.819.1236  
 ben.cleveland@cushwake.com