
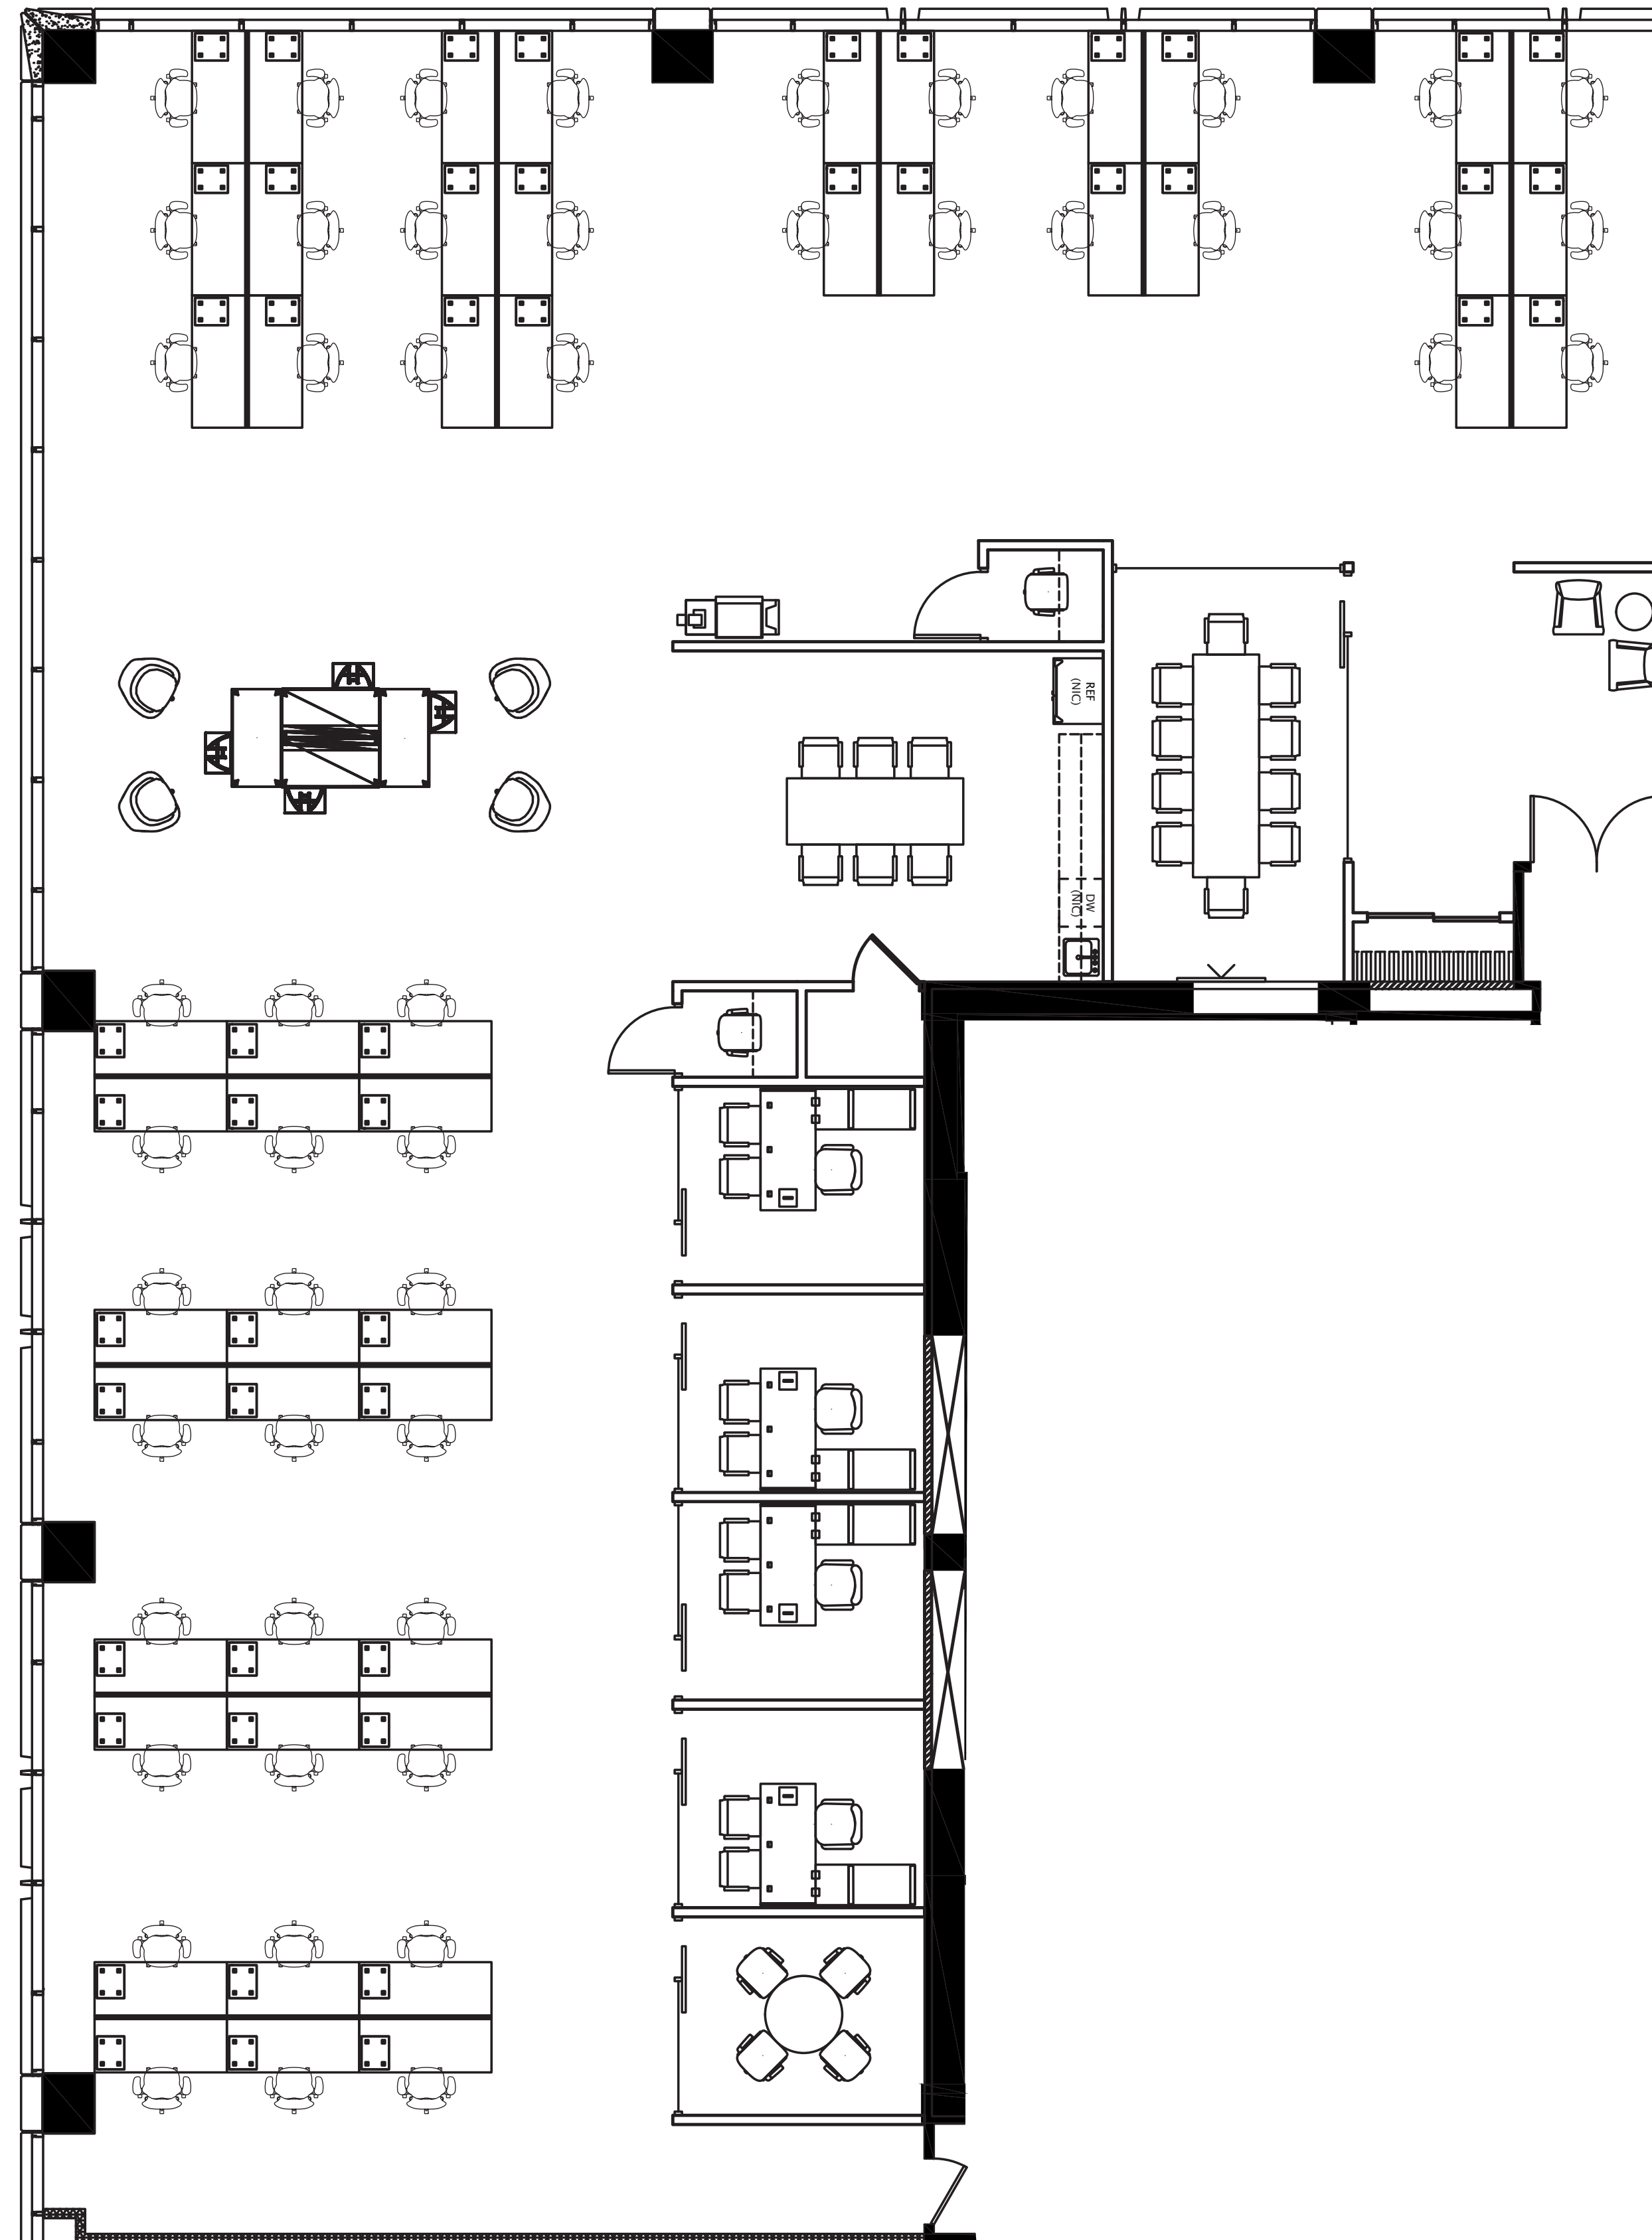


AS-BUILT CONFIGURATION

| | |
|-----------------------|-------|
| OFFICES..... | 4 |
| RECEPTION..... | 1 |
| CONFERENCE ROOMS..... | 2 |
| KITCHEN..... | 1 |
| OPEN WORK AREA..... | +/-50 |

Not to scale, furniture and appliances not included

KEY PLAN

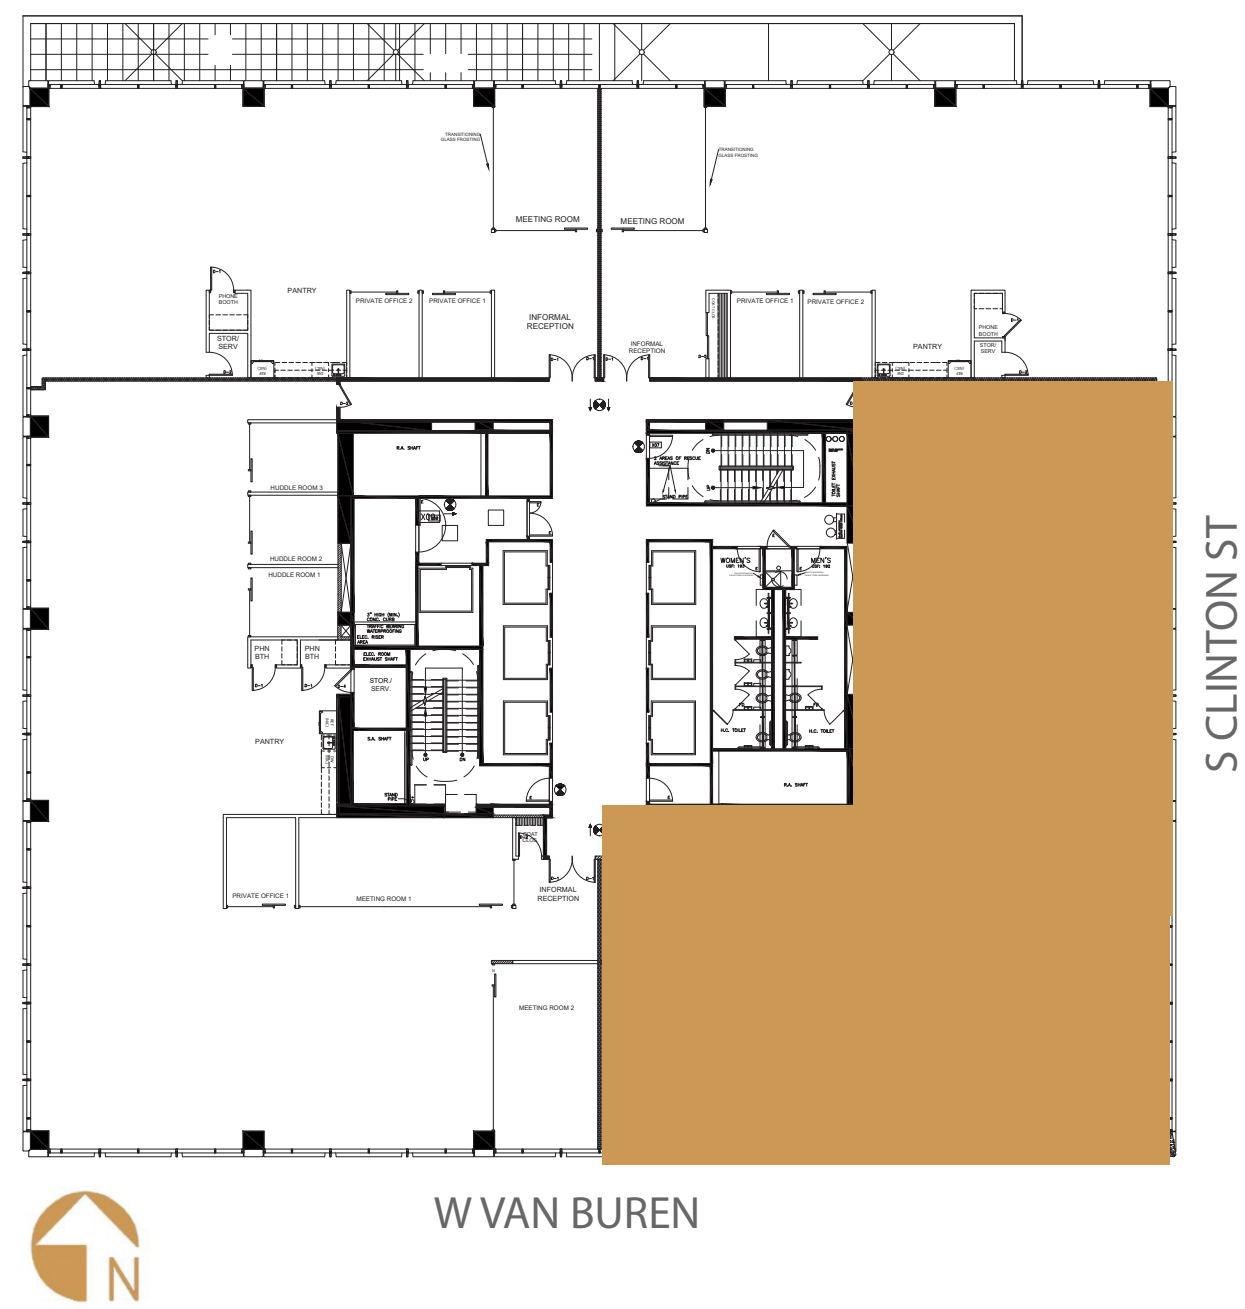

For leasing information please contact:
Mark J. Gunderson
312.448.8645
mark.gunderson@streamrealty.com

Ben Cleveland
312.448.6221
ben.cleveland@streamrealty.com