
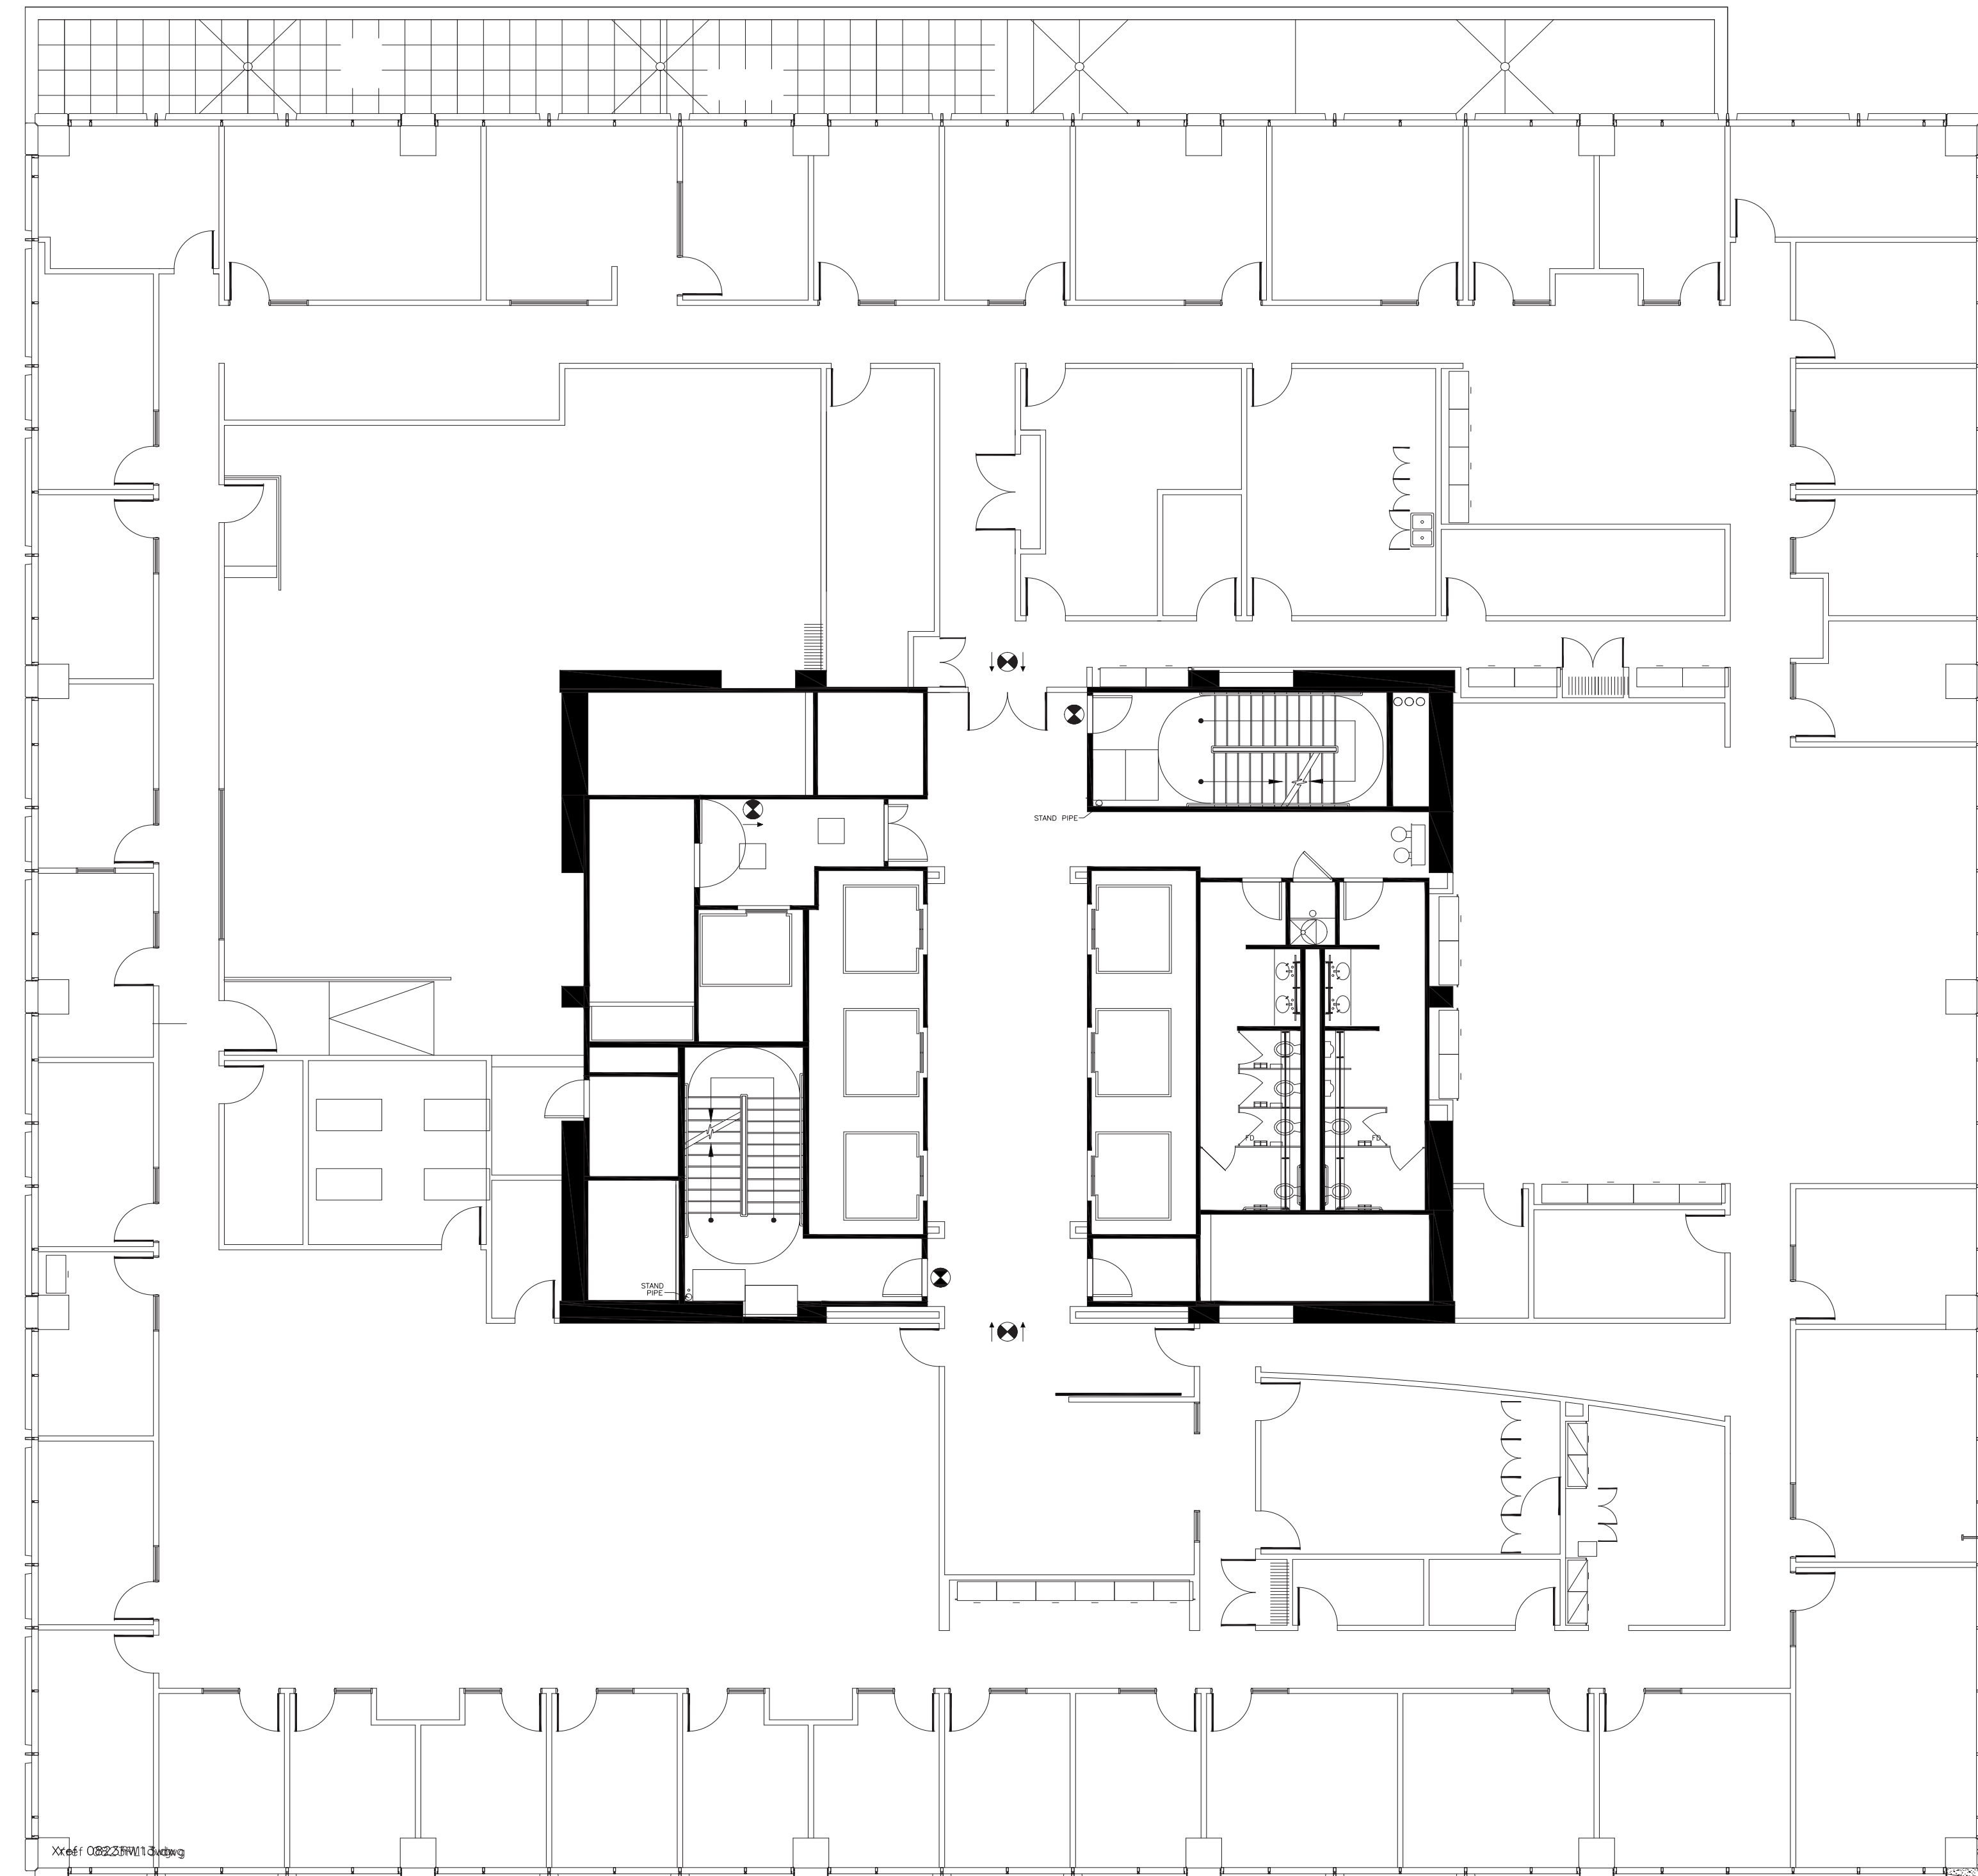


AS-BUILT CONFIGURATION

OFFICES.....	36
RECEPTION.....	1
CONFERENCE ROOMS.....	3
KITCHEN.....	1
OPEN WORK AREA.....	+/-90

Not to scale, furniture and appliances not included

KEY PLAN

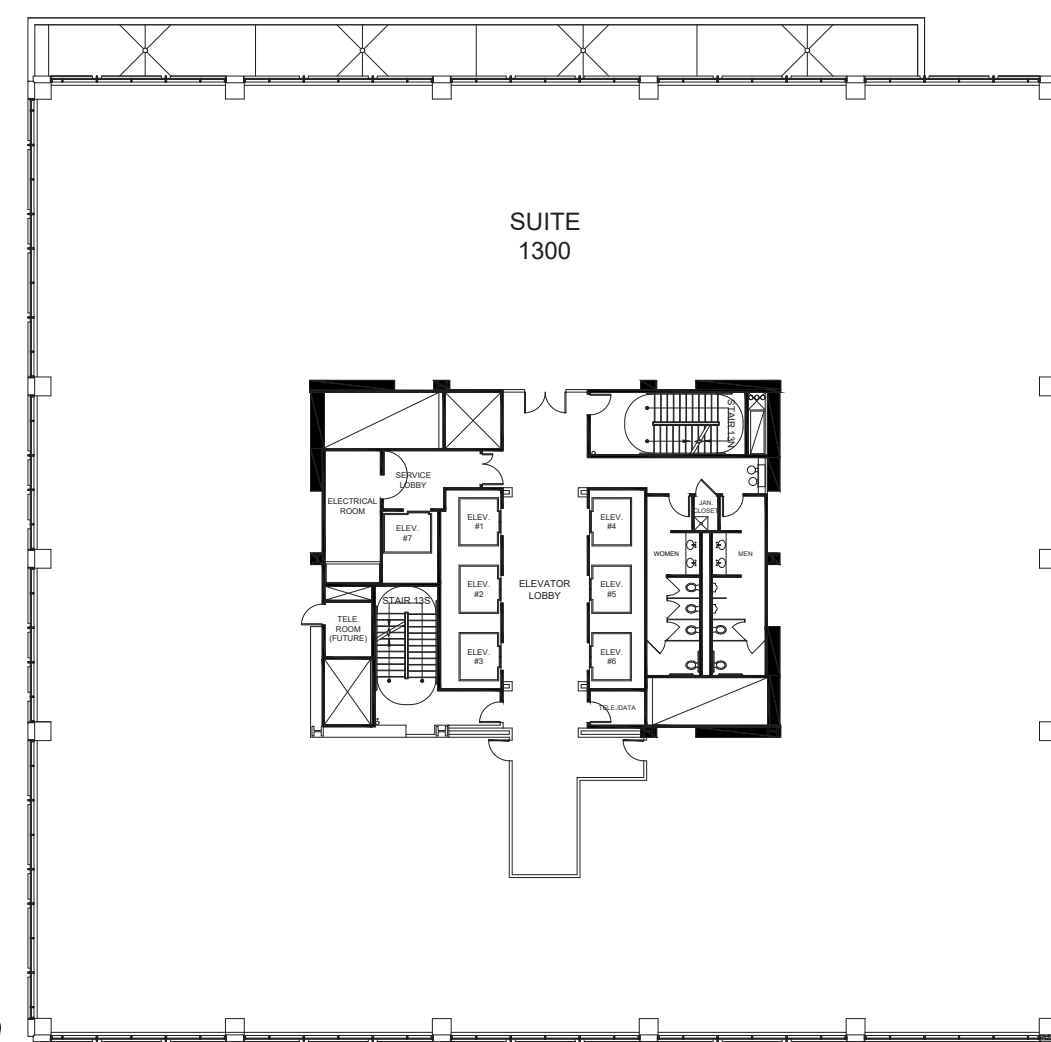

For leasing information please contact:
Mark J. Gunderson
312 819 1236 | mark.gunderson@cushwake.com

Ben Cleveland
312 819 1236 | ben.cleveland@cushwake.com